


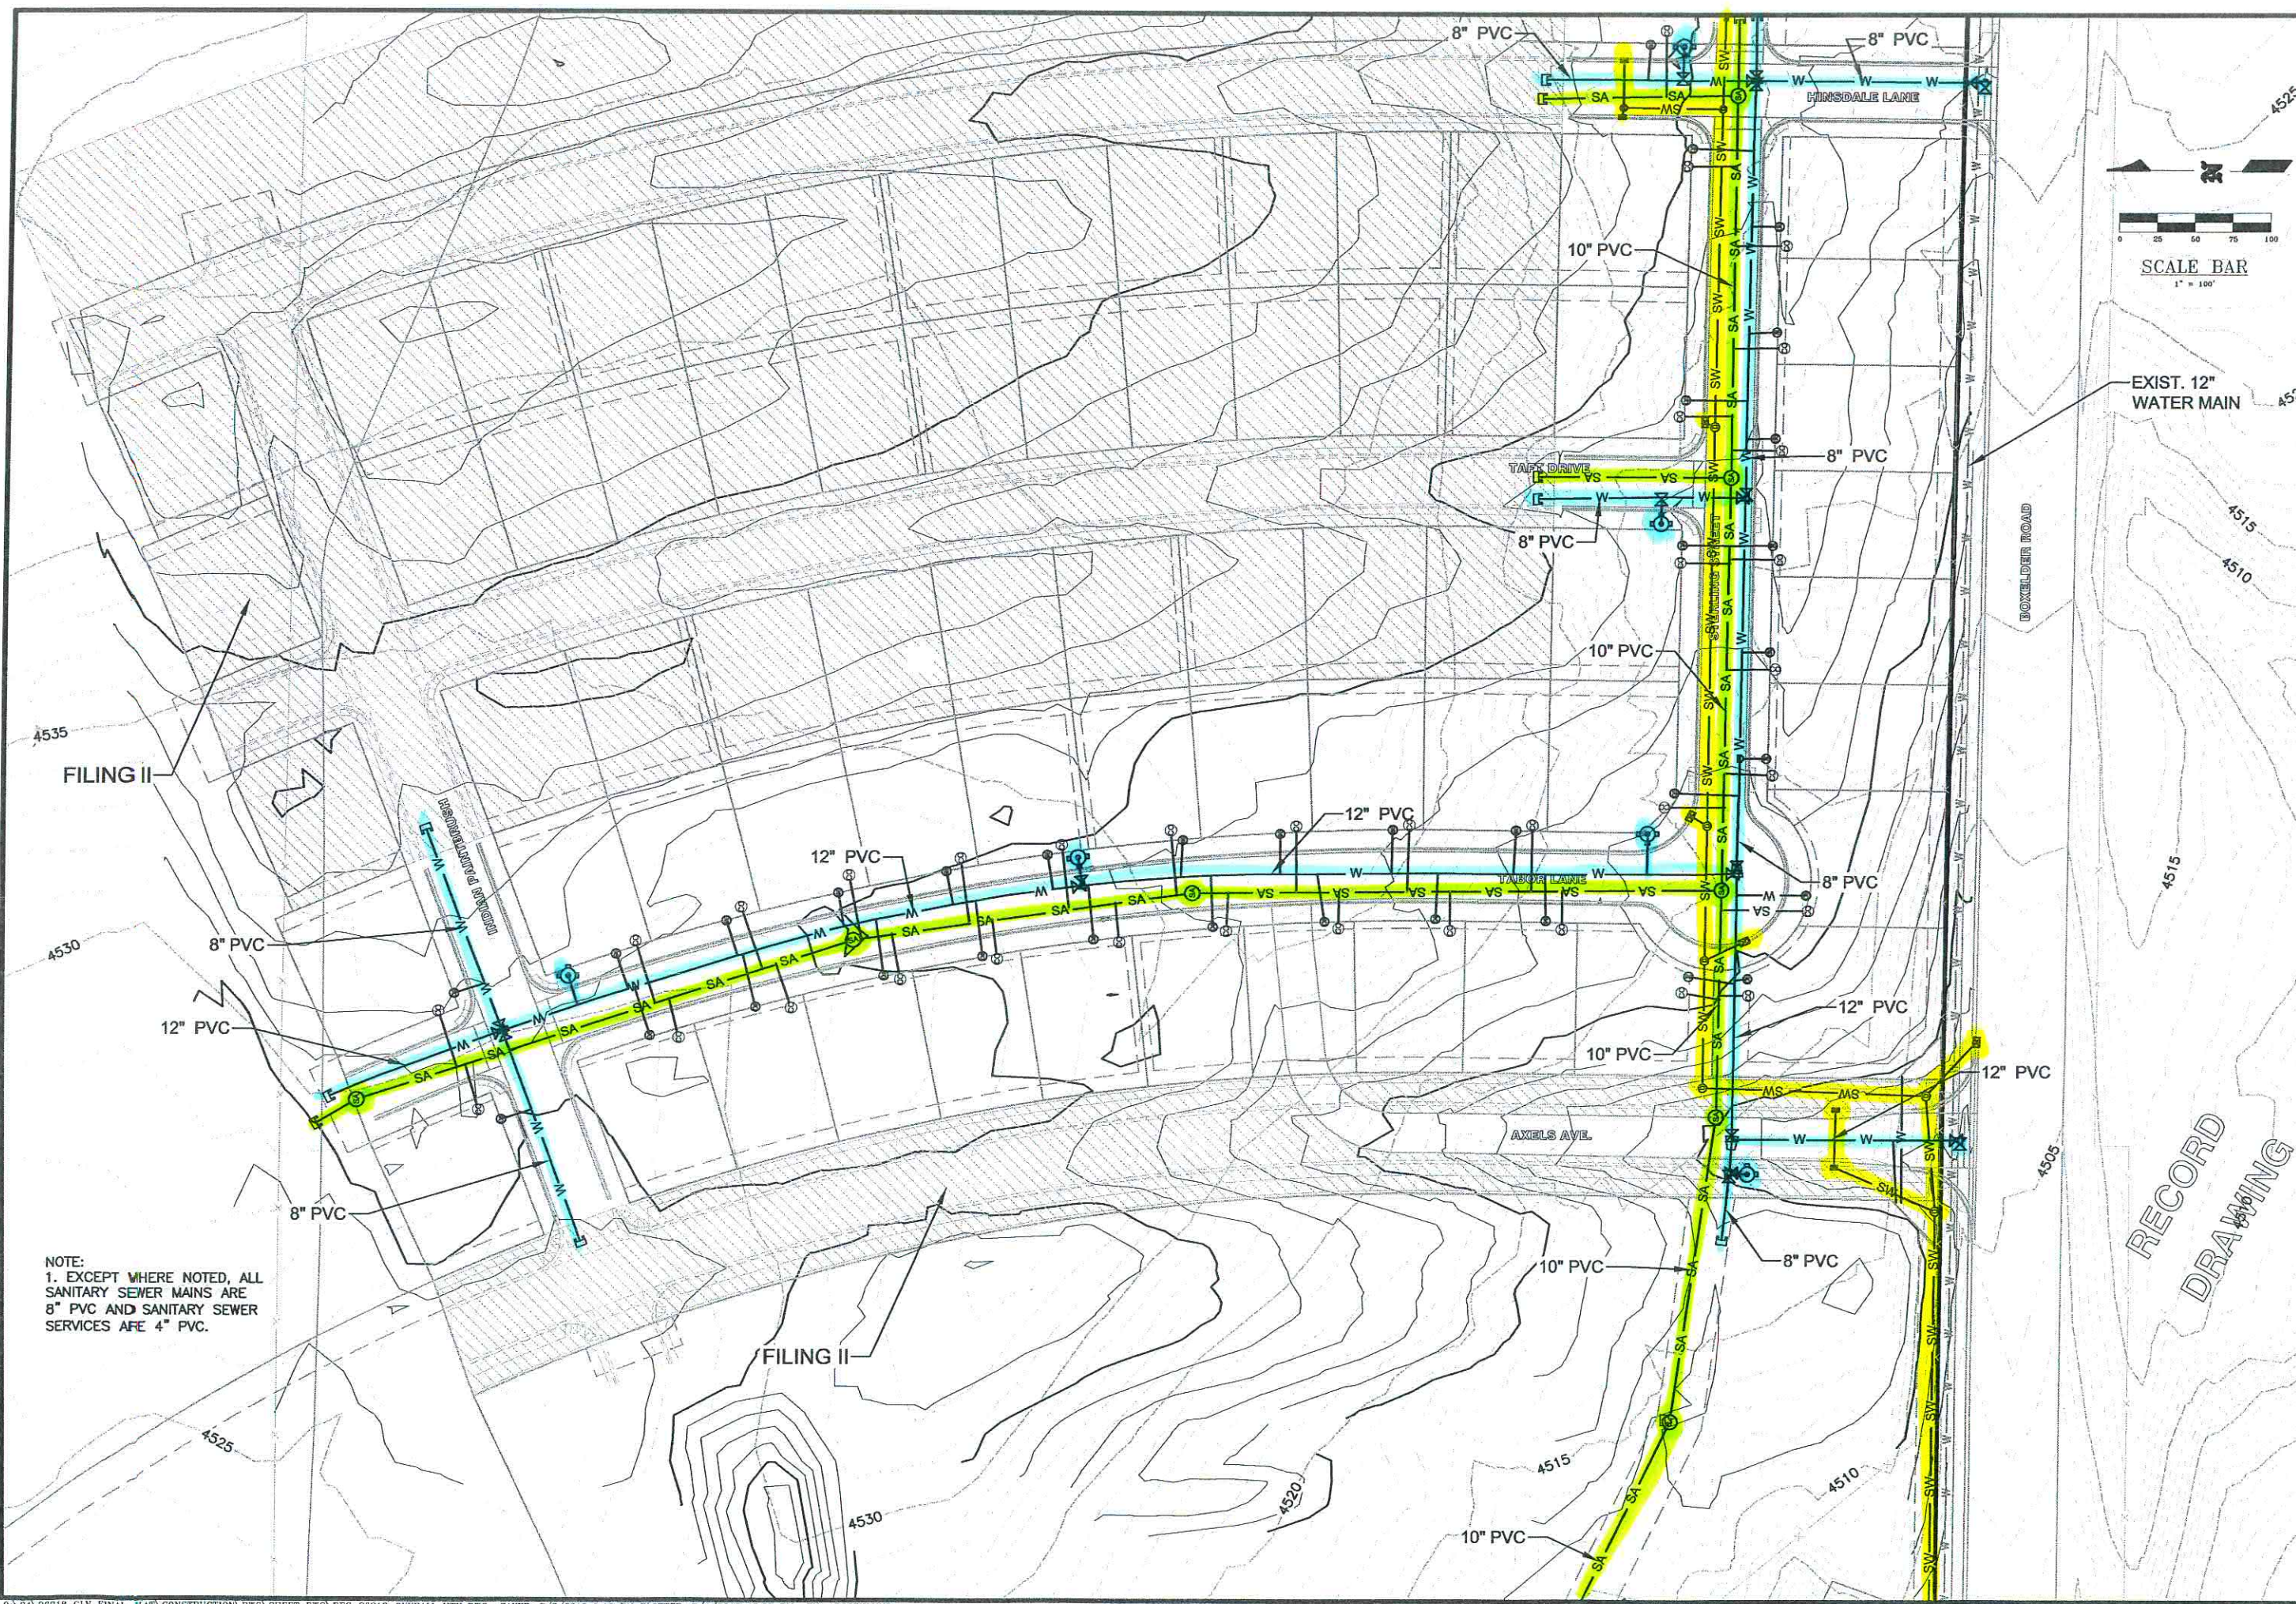


REV. #	REVISION DESCRIPTION	DATE	BY
1	FINAL EDITS	5-20-2012	AR
2	RECORD DRAWINGS	7-2-2013	AR

GARNER LAKE VILLAGE SUBDIVISION
PHASE I, FILING I
OVERALL UTILITY PLAN

DOWL HKM
1901 ENERGY COURT
SUITE 170
GILLETTE, WYOMING 82718
307-686-4181
307-686-4858 (FAX)
DOWLHKM.COM

DATE: 7/2/2012
JOB NO: 502426210.01
DRAWN BY: RC
APPROVED BY: AER

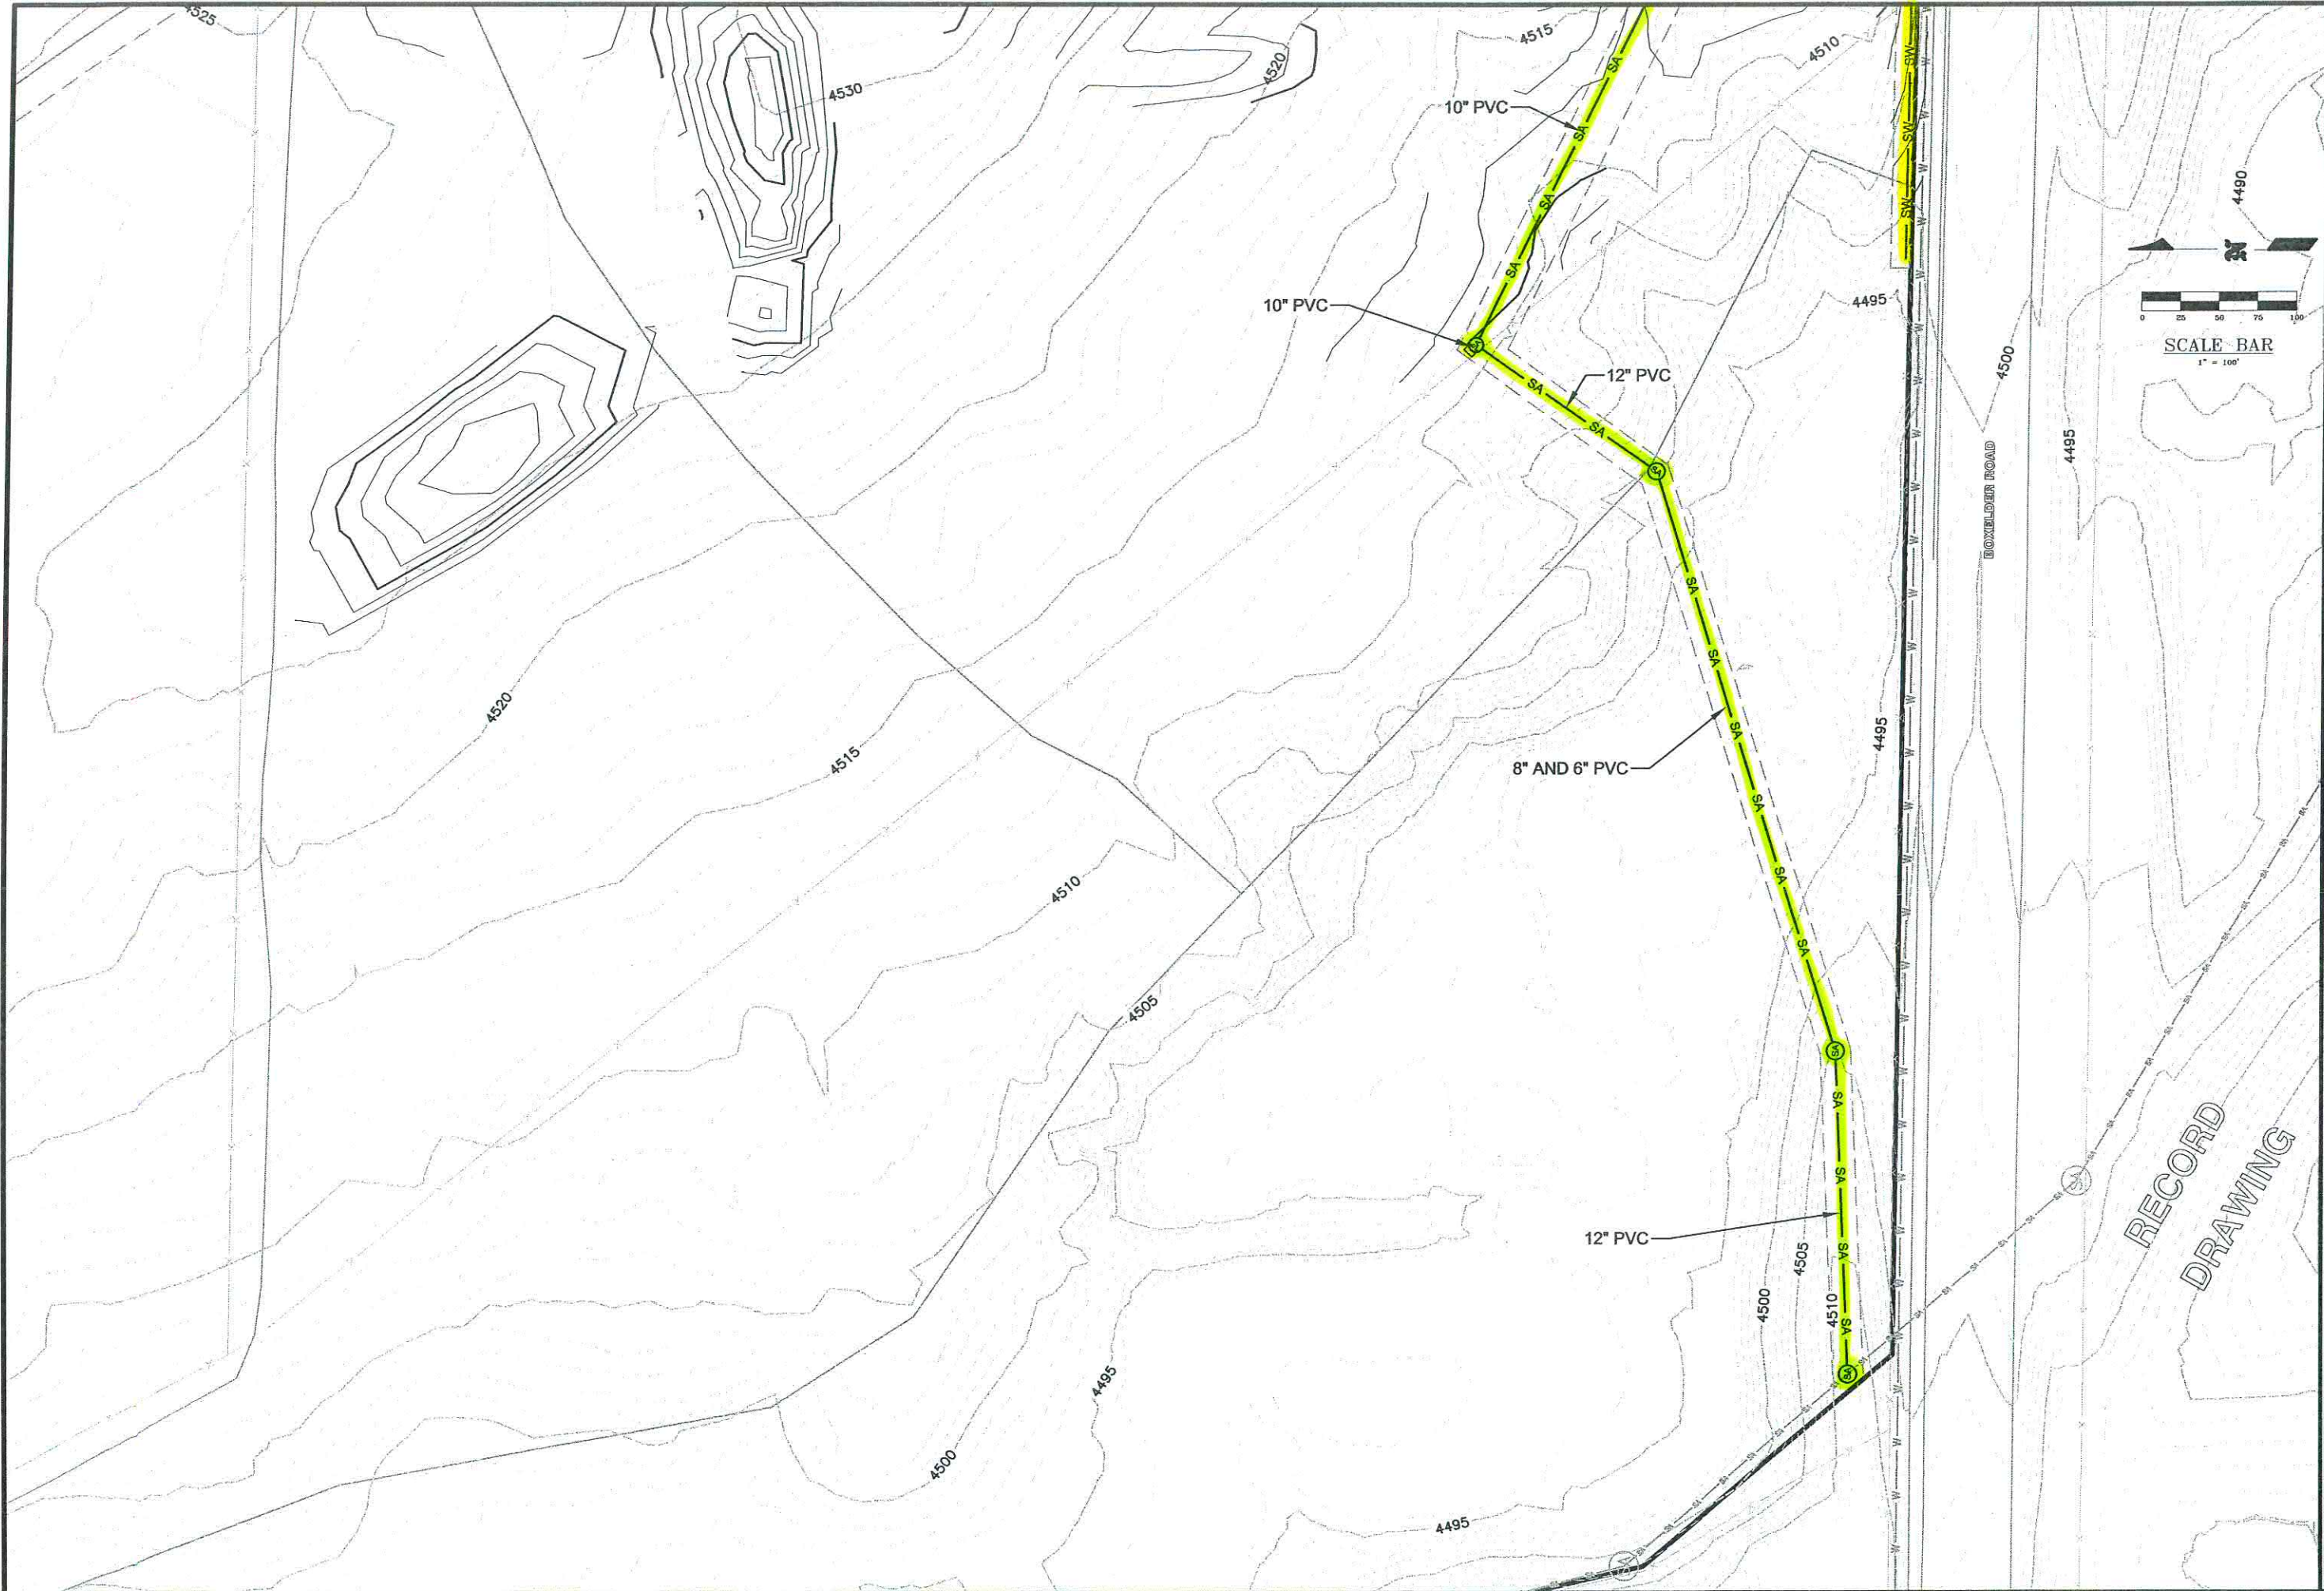

REV. #	REVISION DESCRIPTION	DATE	BY
1	FINAL EDITS	6-29-2012	AR
2	RECORD DRAWINGS	7-2-2013	AR

GARNER LAKE VILLAGE SUBDIVISION

PHASE I, FILING I

OVERALL UTILITY PLAN

DOWL HKM
1901 ENERGY COURT
SUITE 170
GILLETTE, WYOMING 82718
307-686-4181
307-686-4858 (FAX)
DOWLHKM.COM

DATE: 7/2/2012

JOB NO: 502438218.01

DRAWN BY: RC

APPROVED BY: ABR

OVERALL UTILITY PLAN

OU-2