


KEY NOTES

- ① EXISTING 12" PVC WATER MAIN
- ② CONNECT NEW 8" SERVICE TO EXISTING 12" MAIN VIA 8"x12" STAINLESS STEEL TAPPING SLEEVE. INSTALL 8" GATE VALVE 18"-24" FROM EXISTING WATERMAIN.
- ③ INSTALL NEW 8" PVC FIRE SERVICE. PER COG DRAWING SERIES 02665. SEE WA-1 FOR PLAN & PROFILE.
- ③A INSTALL 8" GATE VALVE. CITY OWNERSHIP & MAINTENANCE TO END AT THIS VALVE.
- ③B INSTALL NEW 6" PVC FIRE LINE.
- ④ INSTALL FIRE HYDRANT ASSEMBLY PER COG DRAWING SERIES 02645.
- ⑤ EXISTING 6" PVC WATER PRIVATE MAIN
- ⑥ CONNECT NEW 3" WATER SERVICE TO EXISTING PRIVATE MAIN PER COG DRAWING SERIES 02665.
- ⑦ INSTALL NEW 3" PE WATER SERVICE.
- ⑧ EXISTING 4" PVC SANITARY SERVICE
- ⑨ INSTALL NEW 4" SERVICE WYE AND CLEANOUT.
- ⑩ INSTALL NEW 4" SANITARY SERVICE.
- ⑪ INSTALL NEW 4" SANITARY SERVICE FOR GREASE INTERCEPTOR LINE.
- ⑫ INSTALL NEW STORM DRAIN.
- ⑬ INSTALL NEW STORM SWALE.
- ⑭ NEW TRANSFORMER LOCATION - UTILITY TO INSTALL NEW BURIED POWER SERVICE. COORDINATE W/ UTILITY PROVIDER.
- ⑮ NEW NATURAL GAS SERVICE BY UTILITY. COORDINATE W/ UTILITY PROVIDER.
- ⑯ NEW BURIED COMMUNICATION LINE. COORDINATE W/ UTILITY PROVIDER
- ⑰ SITE LIGHTING. SEE ELECTRICAL PLANS.
- ⑱ INSTALL GREASE INTERCEPTOR. SEE PLUMBING PLANS.
- ⑲ 20' GENERAL UTILITY EASEMENTS

SEE CONNECTION DETAIL BELOW

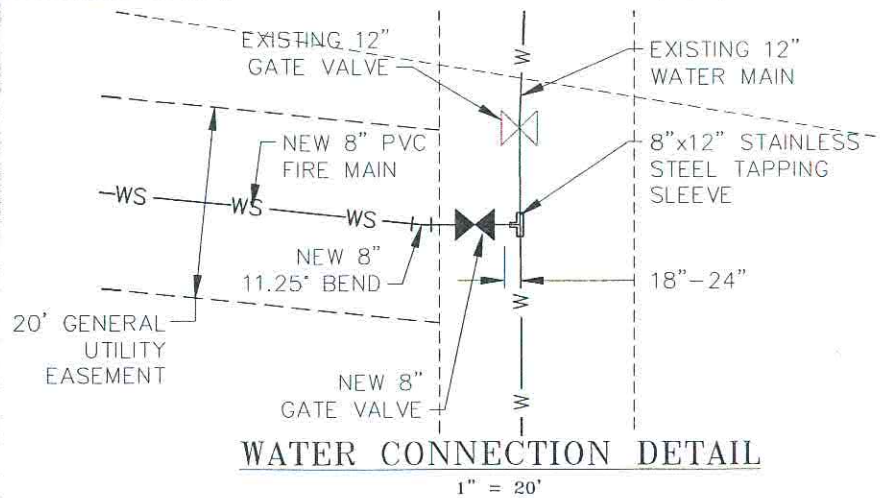

WATER CONNECTION DETAIL
1" = 20'

**AS-CONSTRUCTED DRAWINGS
BELL NOB
GOLF COURSE CLUBHOUSE
UTILITY PLAN**

REV. #	REVISION DESCRIPTION	DATE	BY
1	PER CITY COMMENTS	4-20-13	MIJ

CTA
GILLETTE, WY
(307) 686-7121

DATE:	4/4/2013
JOB NO.:	BELL NOB 100
DRAWN BY:	MIJ
APPROVED BY:	MGW / TS
OVERALL UTILITY PLAN	
OU-2	