


LOCATION MAP
N.T.S.

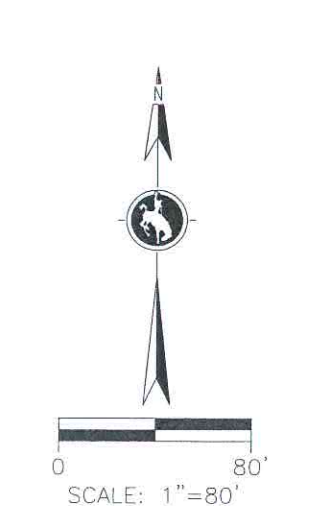

**RECORD
DRAWING**

RECORD DRAWING:
SEE WATER AND SANITARY SEWER
SHEET SETS FOR AS-BUILT LOCATIONS.
NOTE THAT EACH END OF SERVICE
LINE WAS SHORTENED PER OWNER.

RECORD DRAWING:
PREVIOUS RECORD DRAWINGS WERE INCORRECT AS
CONSTRUCTION DID NOT INSTALL DROP FROM INVERT IN
TO INVERT OUT OF EXISTING MANHOLE. UPDATED VALUES
AS SHOWN IN SA-1 - SA-7 SHEET SET. REMAINDER OF
PROPOSED SYSTEM IS LOWER DUE TO THIS.

RECORD DRAWING:
SERVICE LOCATIONS ADJUSTED PER CITY
AGREEMENT WITH CONTRACTOR TO
REDUCE OVERALL PATCH AREA

RECORD DRAWING:
PREVIOUS RECORD DRAWINGS WERE INCORRECT AS
CONSTRUCTION DID NOT INSTALL DROP FROM INVERT IN
TO INVERT OUT OF EXISTING MANHOLE. UPDATED VALUES
AS SHOWN IN SA-1 - SA-7 SHEET SET. REMAINDER
OF PROPOSED SYSTEM IS LOWER DUE TO THIS.

- NOTES:
1. REFER TO WA-1 - WA-7 FOR WATERLINE CONSTRUCTION INFORMATION.
 2. REFER TO SA-1 - SA-7 FOR SANITARY SEWER CONSTRUCTION INFORMATION.
 3. REFER TO SW-1 FOR STORM WATER SYSTEM CONSTRUCTION INFORMATION.

REV. #	REVISION DESCRIPTION	DATE	BY
1	INTERIM RECORD DRAWINGS	12/20/14	APM
2	INTERIM RECORD DRAWINGS	06/19/15	APM
3	FINAL RECORD DRAWINGS	10/23/15	APM

PARKSIDE ESTATES FILING I OVERALL UTILITY LAYOUT

**ECV
ENGINEERS**
511 East 4th Street, Suite 3 • Gillette, Wyoming 82716
307.670.9577 • www.ecvengineers.net

DATE: 08/05/2014
JOB NO: 140057
DRAWN BY: CAD
APPROVED BY: APM