


Q:\22\26343 FCA Site Plan\CAD\Record\MCH4-FCA-SITEPLAN-Rldwg PLOT DATE 2015-11-2 07:56 SAVED DATE 2015-11-02 07:17 USER: pncgwat

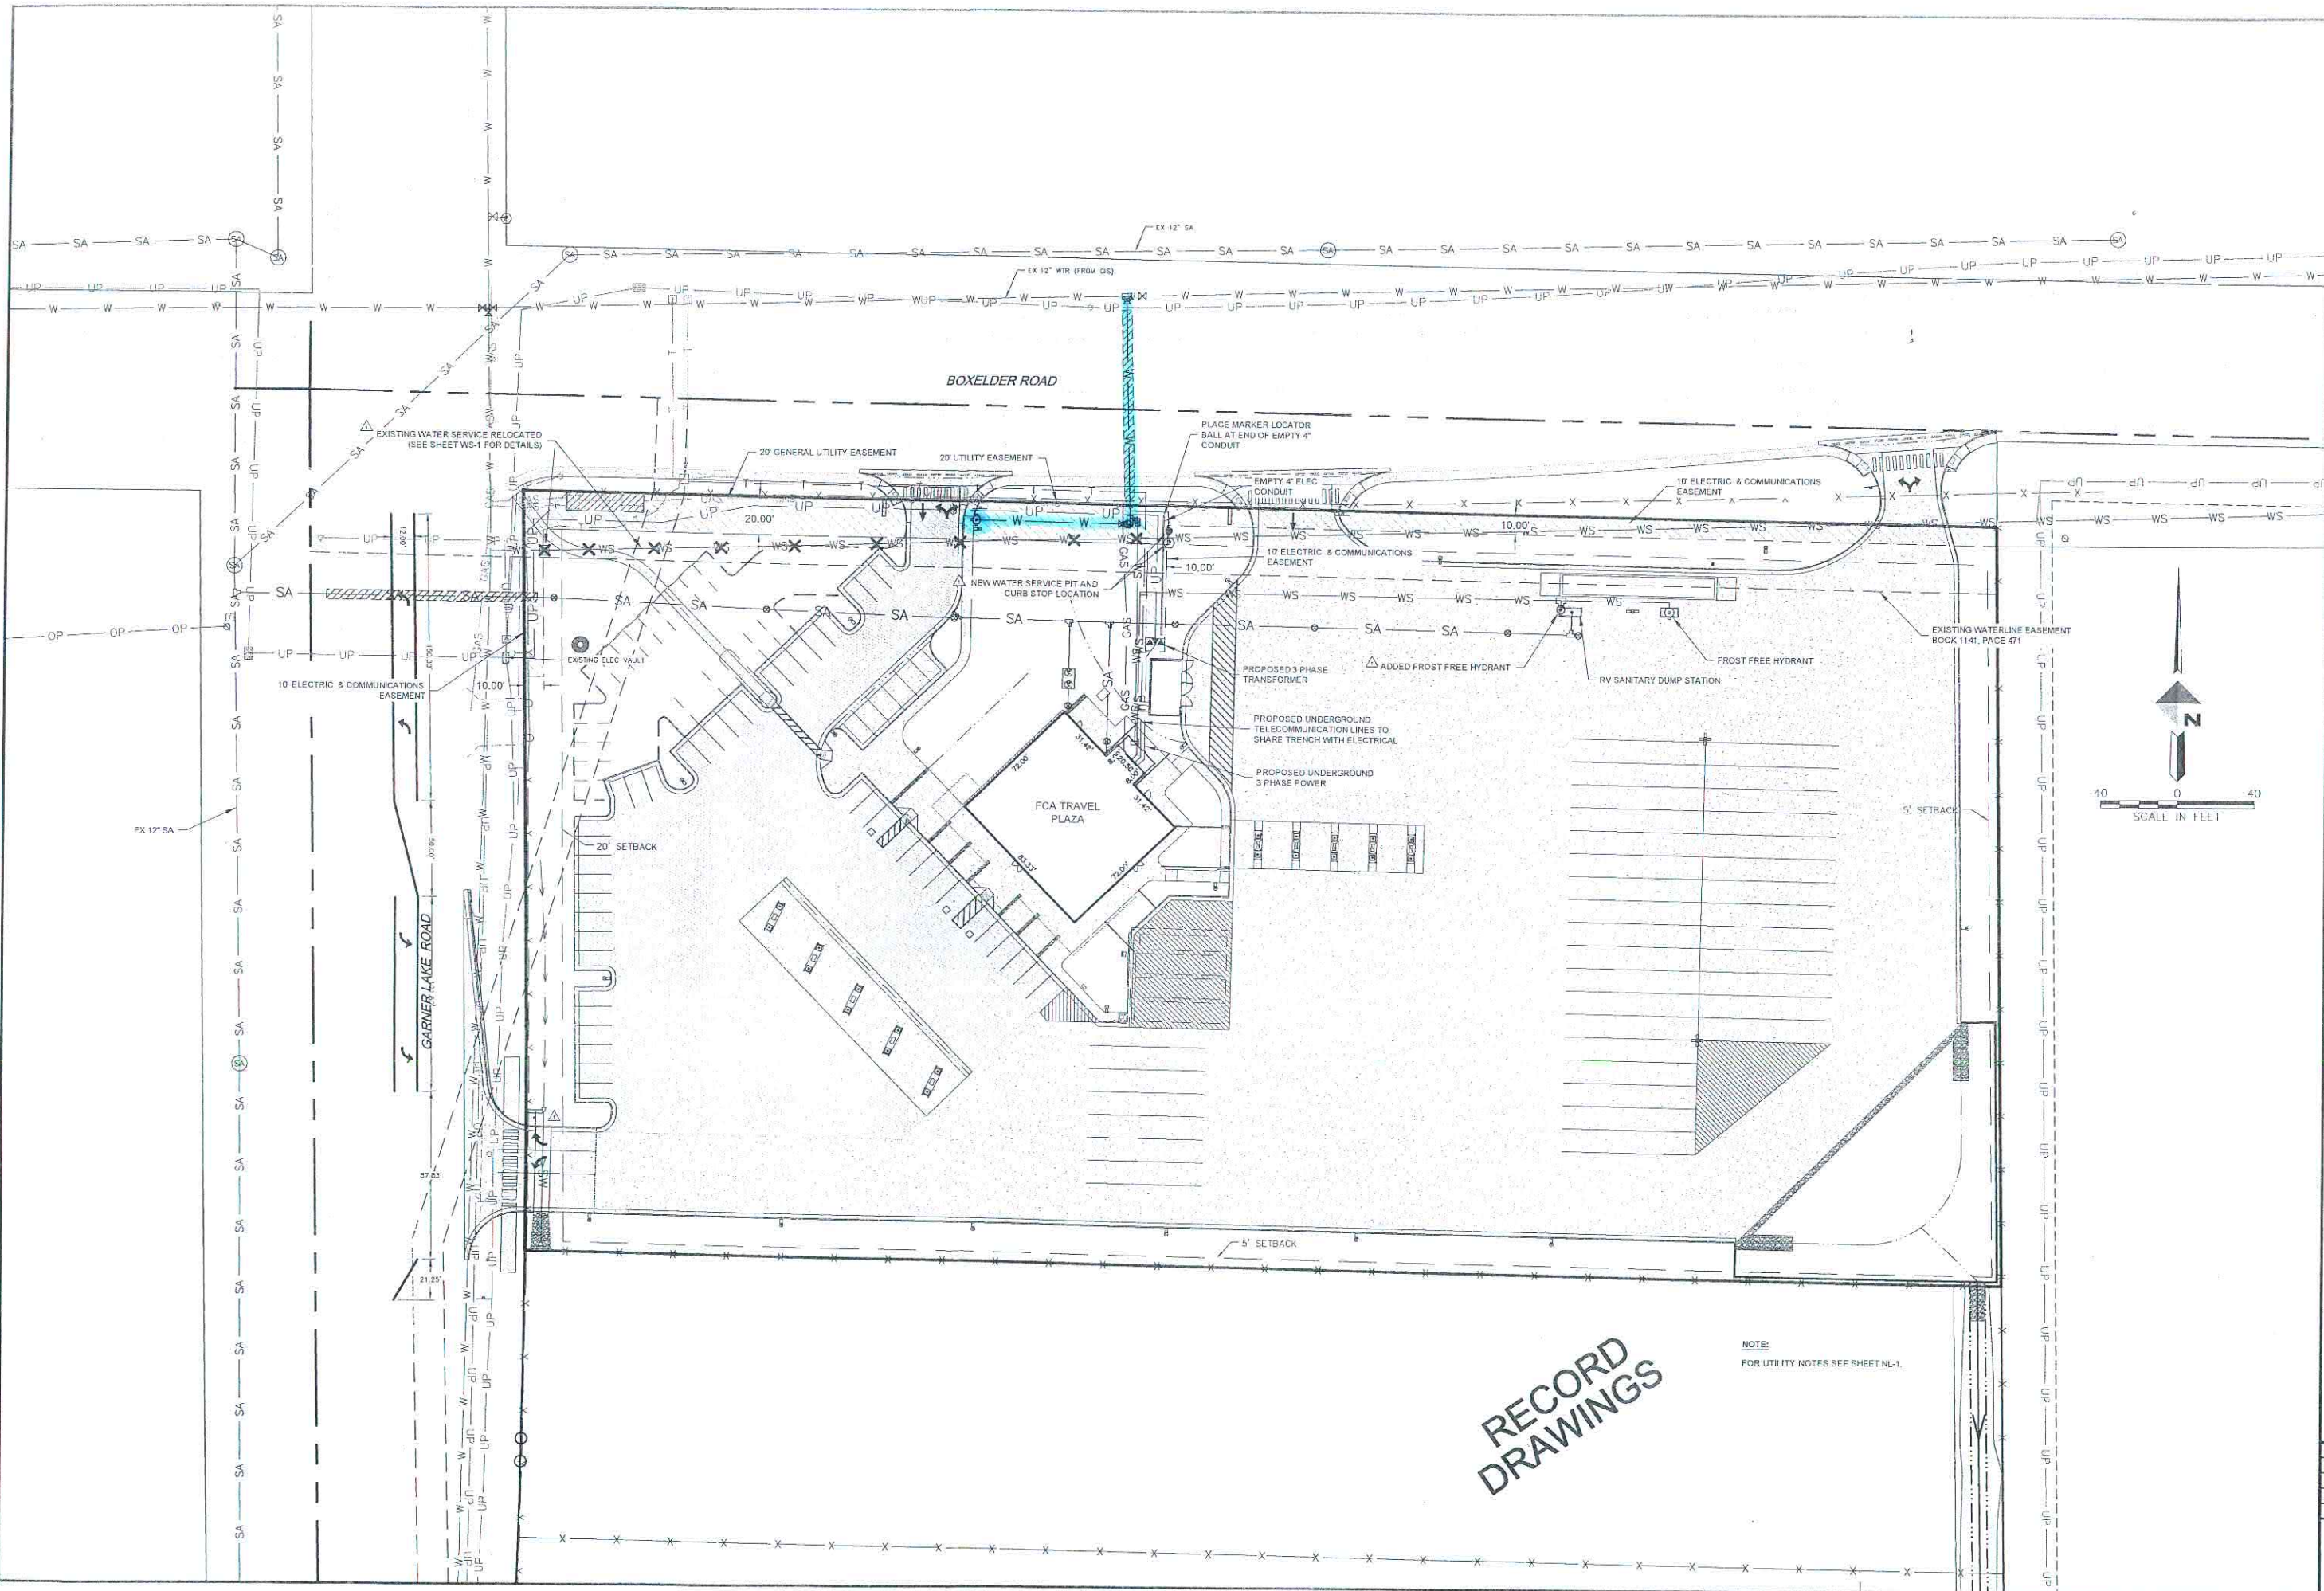

RECORD
DRAWINGS

REV.	DESCRIPTION	DATE	BY
1	RECORD DRAWINGS	11/02/15	JB

DOWL
1801 Energy Court, Suite 170
Gillette, Wyoming 82718
307-686-4191
www.dowlhkm.com

FCA TRAVEL PLAZA
UTILITY PLAN

PROJECT 5322.26343.01
DATE 03/12/2015
DRAWN BY JB
APPROVED BY AS
© DOWLHKM 2014
SHEET
OU-1
OF 23