



- NOTES:
1. SEE SHEET WA-1 FOR WATER PLANS AND PROFILES.
 2. SEE SHEETS DT-5A TO DT-5C FOR WATER DETAILS.
 3. SEE SHEET SA-1 & SA-2 FOR SANITARY SEWER PLANS & PROFILES.
 4. SEE SHEETS DT-4A TO DT-4C FOR SANITARY SEWER DETAILS.
 5. SEE SHEETS SW-1 TO SW-3 FOR STORM SEWER PLANS & PROFILES.
 6. SEE SHEETS DT-6A TO DT-6B FOR STORM SEWER DETAILS.

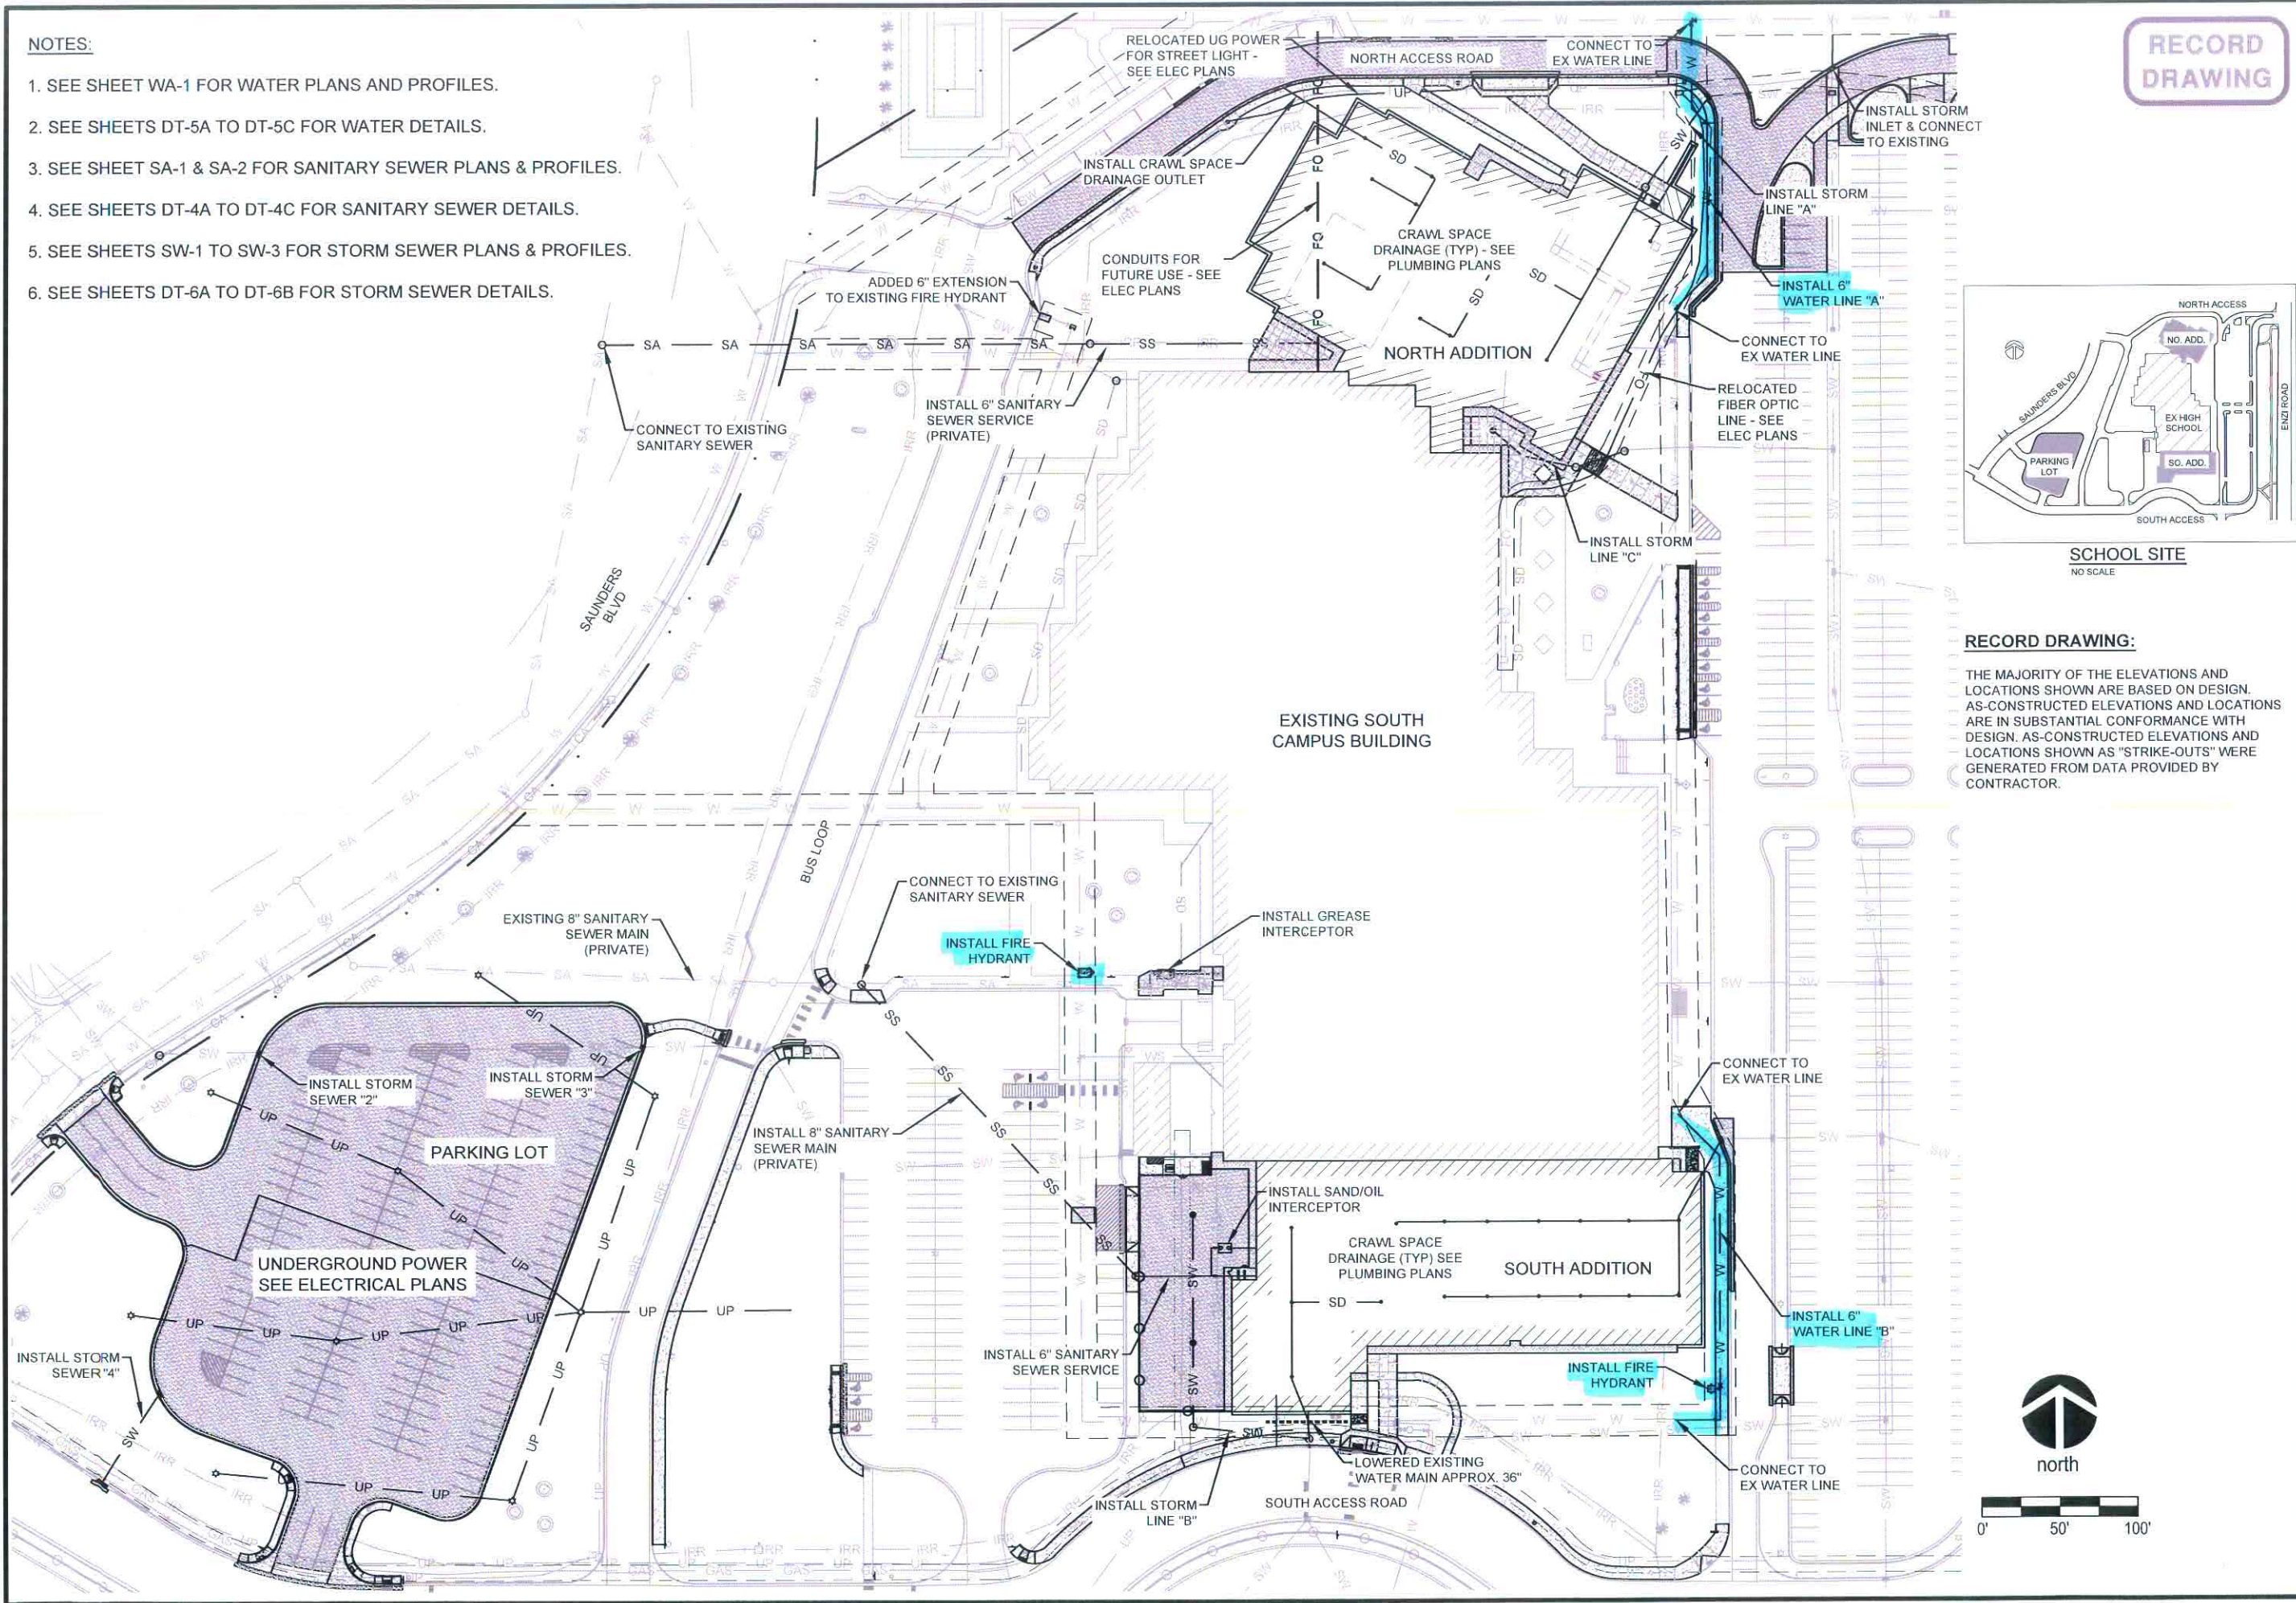

RECORD
DRAWING

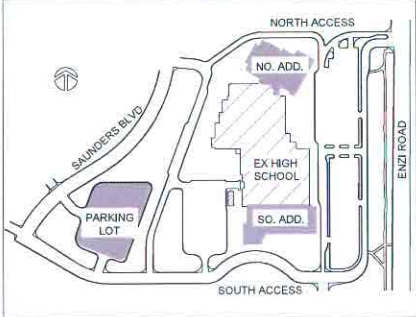

SCHOOL SITE
NO SCALE

RECORD DRAWING:
THE MAJORITY OF THE ELEVATIONS AND LOCATIONS SHOWN ARE BASED ON DESIGN. AS-CONSTRUCTED ELEVATIONS AND LOCATIONS ARE IN SUBSTANTIAL CONFORMANCE WITH DESIGN. AS-CONSTRUCTED ELEVATIONS AND LOCATIONS SHOWN AS "STRIKE-OUTS" WERE GENERATED FROM DATA PROVIDED BY CONTRACTOR.

CC HIGH SCHOOL SOUTH CAMPUS
CAMPBELL CO SCHOOL DIST NO 1
OVERALL UTILITY PLAN



CONSOLIDATED ENGINEERS, INC.
316 SO GILLETTE AVE PO BOX 1035 GILLETTE, WYOMING 82717
PH. (307) 682-9768 FAX (307) 686-6665

DATE: 02/12/15
JOB NO: 150243
DRAWN BY: CAB
APPROVED BY: KRK

OVERALL UTILITY PLAN
OU-1